

*Re-record to correct legal description
ENOCH G. BAKER, ET UX, GRANTORS

TO

DEED OF GIFT


FRANKIE BAKER LASHLEE, GRANTEE

FOR AND IN CONSIDERATION of the love and affection we have for the
Grantee, We, ENOCH G. BAKER and wife, JULIA B. BAKER, give, convey, and
warrant unto FRANKIE BAKER LASHLEE the land in DeSoto County, Mississippi,
described as follows, to-wit:

SEE EXHIBIT "A" PAGE ONE AND TWO ATTACHED FOR
LEGAL DESCRIPTION.

By acceptance of this Deed, the parties agree this conveyance is made subject to
subdivision, health department, zoning and other regulations in effect in DeSoto
County, Mississippi; restrictive covenants of the subdivision; and rights of way and
easements for public roads and public utilities and any mineral or mineral rights,
including oil and gas, leased, granted or retained by current or prior owners. Taxes for
2004 shall be paid by Grantee when due. Possession is to be given upon delivery of
this Deed.

EXECUTED this the 26th day of May, 2004

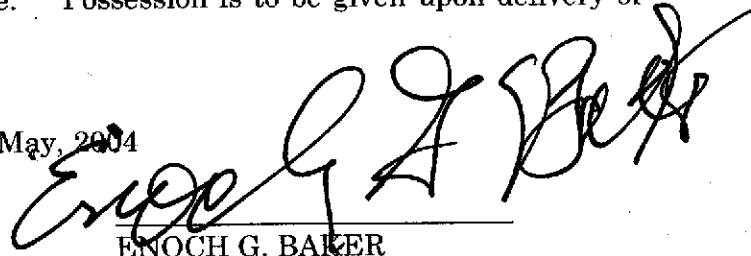
ENOCH G. BAKER


JULIA B. BAKER, GRANTORS

STATE MS.-DESOTO CO. ^{be}
FILED
MAY 27 4 21 PM '04 ^{ps}


OK 473 PG 132
W.E. DAVIS CH. CLK.

OBrien
gov

BK0473PG0133

STATE OF MISSISSIPPI
COUNTY OF DESOTO

This day personally appeared before me, the undersigned authority in and for said county and state, the within named Enoch G. Baker and Wife, Julia B. Baker, who acknowledged signing and delivering the above and foregoing Deed of Gift on the day and year therein mentioned as a free and voluntary act and deed and for the purposes therein expressed.

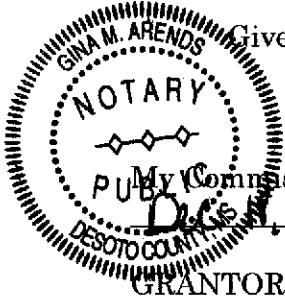

Given under my hand and official seal of office this 26 day of May, 2004.

Gina M. Arends
Notary Public

My Commission Expires: Dec 1, 2006

GRANTOR'S ADDRESS: 2866 Church Road, Horn Lake, MS 38637
Home Phone #: 662-393-7823 Work Phone #: n/a

GRANTEE'S ADDRESS: Same as above
Home Phone #: Same Work Phone #: N/A

Prepared by:
Walker, Brown & Brown, P. A.
P. O. Box 276
Hernando, MS 38632
(662) 429-5277
(901) 521-9292
mwb baker to lashlee deed of gift 04


1.0 acres being part of the southwest quarter of section 3, township 2 south, range 8 west, DeSoto County, Mississippi and described as follows;

Commenceing at the southwest corner of section 3, township 2 south, range 8 west. Said point being at the intersection of Church and Tulane Roads. Thence S 88°20'48"E-679.78' along Church Road to a point. Thence N 01°39'12"E-40.0' to a 3/8 rebar on the north right of way of Church Road. Said point being at the southwest corner of said 1.0 acres and the point of beginning. Thence continuing N 01°39'12"E-244.62' to a 3/8 rebar. Thence S 88°20'48"E-178.07' to a 3/8 rebar. Thence S 01°39'12"W-244.62' to a 3/8 rebar on the north right of way of Church Road. Thence N 88°20'48"W-178.07' along said right of way to the point of beginning. Parcel being part of that property as recorded in deed book ~~XX~~ page ~~XX~~ of the office of Chancery Clerk, DeSoto County, Mississippi.


*60

* 389

BK0473PG0135

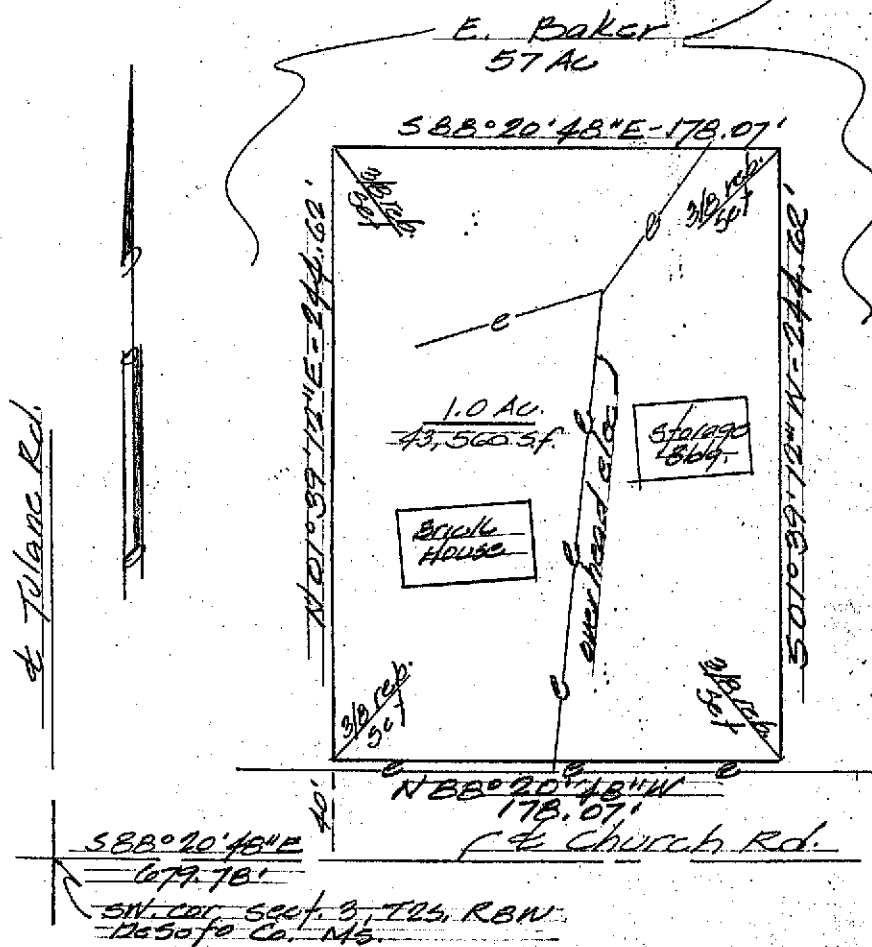

Boundary Survey
1.0 AC. SN 1/4 Sect. 3, T25, R2W, DeSoto Co. Ms.
Scale 1" = 60'

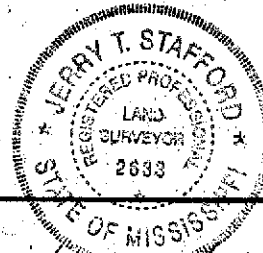

Field Work Date 11 May 04
 Trv. Close Angle 0010005 DST 0.05' Ref. 64/129, 50/195

I HEREBY CERTIFY THAT I HAVE SURVEYED THE PROPERTY AS SHOWN HEREON FROM PHYSICAL FEATURES FOUND ON THE GROUND AND DEEDS OF RECORD, AND THAT THIS PLAT IS A TRUE AND CORRECT EXEMPLIFICATION OF A CLASS B SURVEY. ALSO, ACCORDING TO FIA MAP NO. 2903300040 DATED 2 May 90 THIS PROPERTY IS NOT LOCATED IN A HUD IDENTIFIED FLOOD HAZARD ZONE. CERTIFIED TO THIS THE 14 DAY OF May 2004.

Jerry T. Stafford
 JERRY T. STAFFORD RLS # 2633

STAFFORD SURVEYING - 6710 POPLAR CORNER RD - WALLS, MS 38680
 (662) 781-0310 TEL / FAX